


Internal Line - LLC
 Interiors Fit-out Contracting
 Dubai: t 971 4 880 3835, f 971 4 880 3845
 P.O. Box 49353 / 50221, Dubai
 Abu Dhabi: t 9712 627 7103, f 971 2 627 7106
 P.O. Box 94056, Abu Dhabi

GENERAL NOTES :
 THIS IS A PROPERTY OF INTERNAL LINE
 IT IS NOT TO BE USED OR REPRODUCED
 INTERIOR DESIGN LLC.
 WITHOUT WRITTEN CONSENT FROM
 INTERNAL LINE INTERIOR DESIGN.
 1. ALL DIM. ARE IN MM.
 2. MEASUREMENTS NOT TO BE SCALED
 FROM DRAWING.
 3. ALL DIMENSIONS TO BE VERIFIED ON
 SITE BY THE CONTRACTOR.

COPYRIGHT NOTICE
 THIS DRAWING AND ANY REVISION THEREOF IS
 PROPERTY OF INTERNAL LINE INTERIOR DESIGN, UAE.
 THIRD PARTY IS PROHIBITED WITHOUT PRIOR WRITTEN
 CONSENT OR PERMISSION OF INTERNAL LINE INTERIOR
 DESIGN, UAE.

ISSUED FOR	DATE	INITIALS
<input type="checkbox"/> REFERENCE ONLY		
<input checked="" type="checkbox"/> APPROVAL		
<input type="checkbox"/> TENDERING		
<input type="checkbox"/> GOOD FOR CONSTRUCTION		

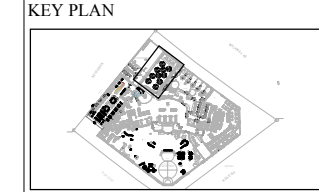

Rev.	DESCRIPTION	Date:	DRN	CHK	APR
01	AS PER CLIENT COMMENTS	15-11-2016	DEXTER	ARIES	
02	AS BUILT	18-05-2017	XTN	MARC	

CLIENT
 MR. EISA SAEED EISA
 AL KHALIL

PROJECT
 FORTUNE GROUP OF HOTEL
 ON PLOT NO. BB.A05.025
 AT BUSINESS BAY, DUBAI

CLIENT NAME: _____ SIGNATURE: _____

DRAWING TITLE:
 FLOORING LAYOUT
 BALL ROOM
 THIRD FLOOR

DRAWN BY:	CHECKED BY:	APPROVED BY:	SHEET SIZE:
KASHIF	Marc		A2
DATE:	PROJ. NO.:	SCALE:	REV
14-02-2016		AS SHOWN	
DWG SERIAL NO	ARCH-ILID-FOR-BR-AR-02	DWG NO.:	AR-02

200 MM RAISED FLOORING
 WITH CARPET FLOORING
 AS PER APPROVED
 SAMPLE & DESIGN **CR-02**

CARPET FLOORING AS
 PER APPROVED SAMPLE
 & DESIGN **EF27003 EGE CARPETS**


CARPET FLOORING AS
 PER APPROVED SAMPLE
 & DESIGN **EF27003 EGE CARPETS**

ALUMINUM "L" SHAPED
 ANGLE ON THE EDGE OF
 RAISE FLOOR AS PER
 APPROVED SAMPLE

200 MM RAISED FLOORING
 WITH CARPET FLOORING
 AS PER APPROVED
 SAMPLE & DESIGN **CR-02**

CARPET FLOORING AS
 PER APPROVED SAMPLE
 & DESIGN
EF27003 EGE CARPETS

CARPET FLOORING AS
 PER APPROVED SAMPLE
 & DESIGN **EF27003 EGE
 CARPETS**

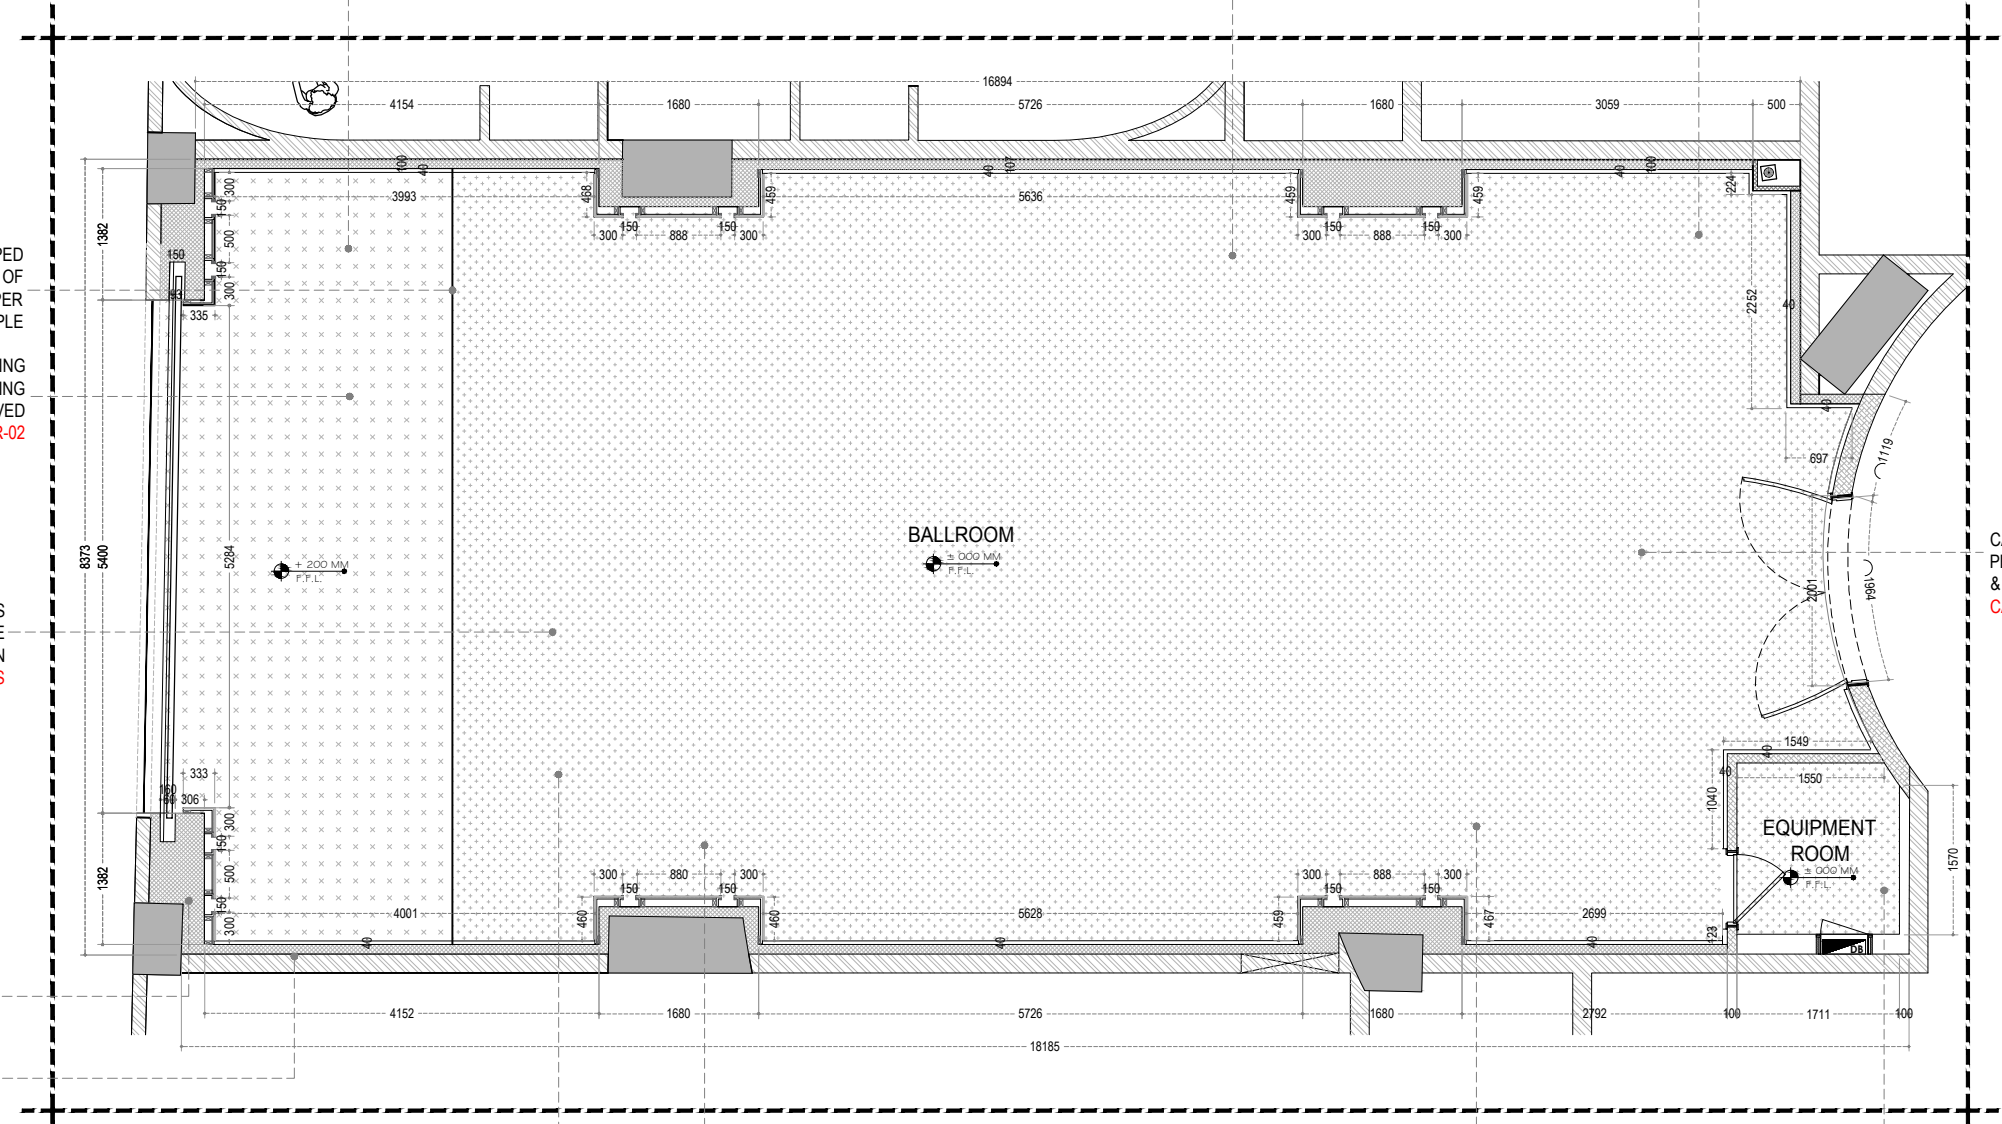

FLOORING LAYOUT
 SCALE: 1:70 MTS

CARPET FLOORING AS PER
 APPROVED SAMPLE & DESIGN
EF27003 EGE CARPETS

CARPET FLOORING AS PER
 APPROVED SAMPLE & DESIGN
EF27003 EGE CARPETS

CARPET FLOORING AS PER
 APPROVED SAMPLE & DESIGN
EF27003 EGE CARPETS

AS BUILT

LEGEND:

CODE	HATCH	IMAGE	DESCRIPTION
EF27003 EGE CARPETS			CARPET FLOORING AS PER APPROVE SAMPLE & DESIGN EF27003 EGE CARPETS
CR-02			CARPET FLOORING AS PER APPROVE SAMPLE & DESIGN CR-02